



AS BUILT SITE PLAN

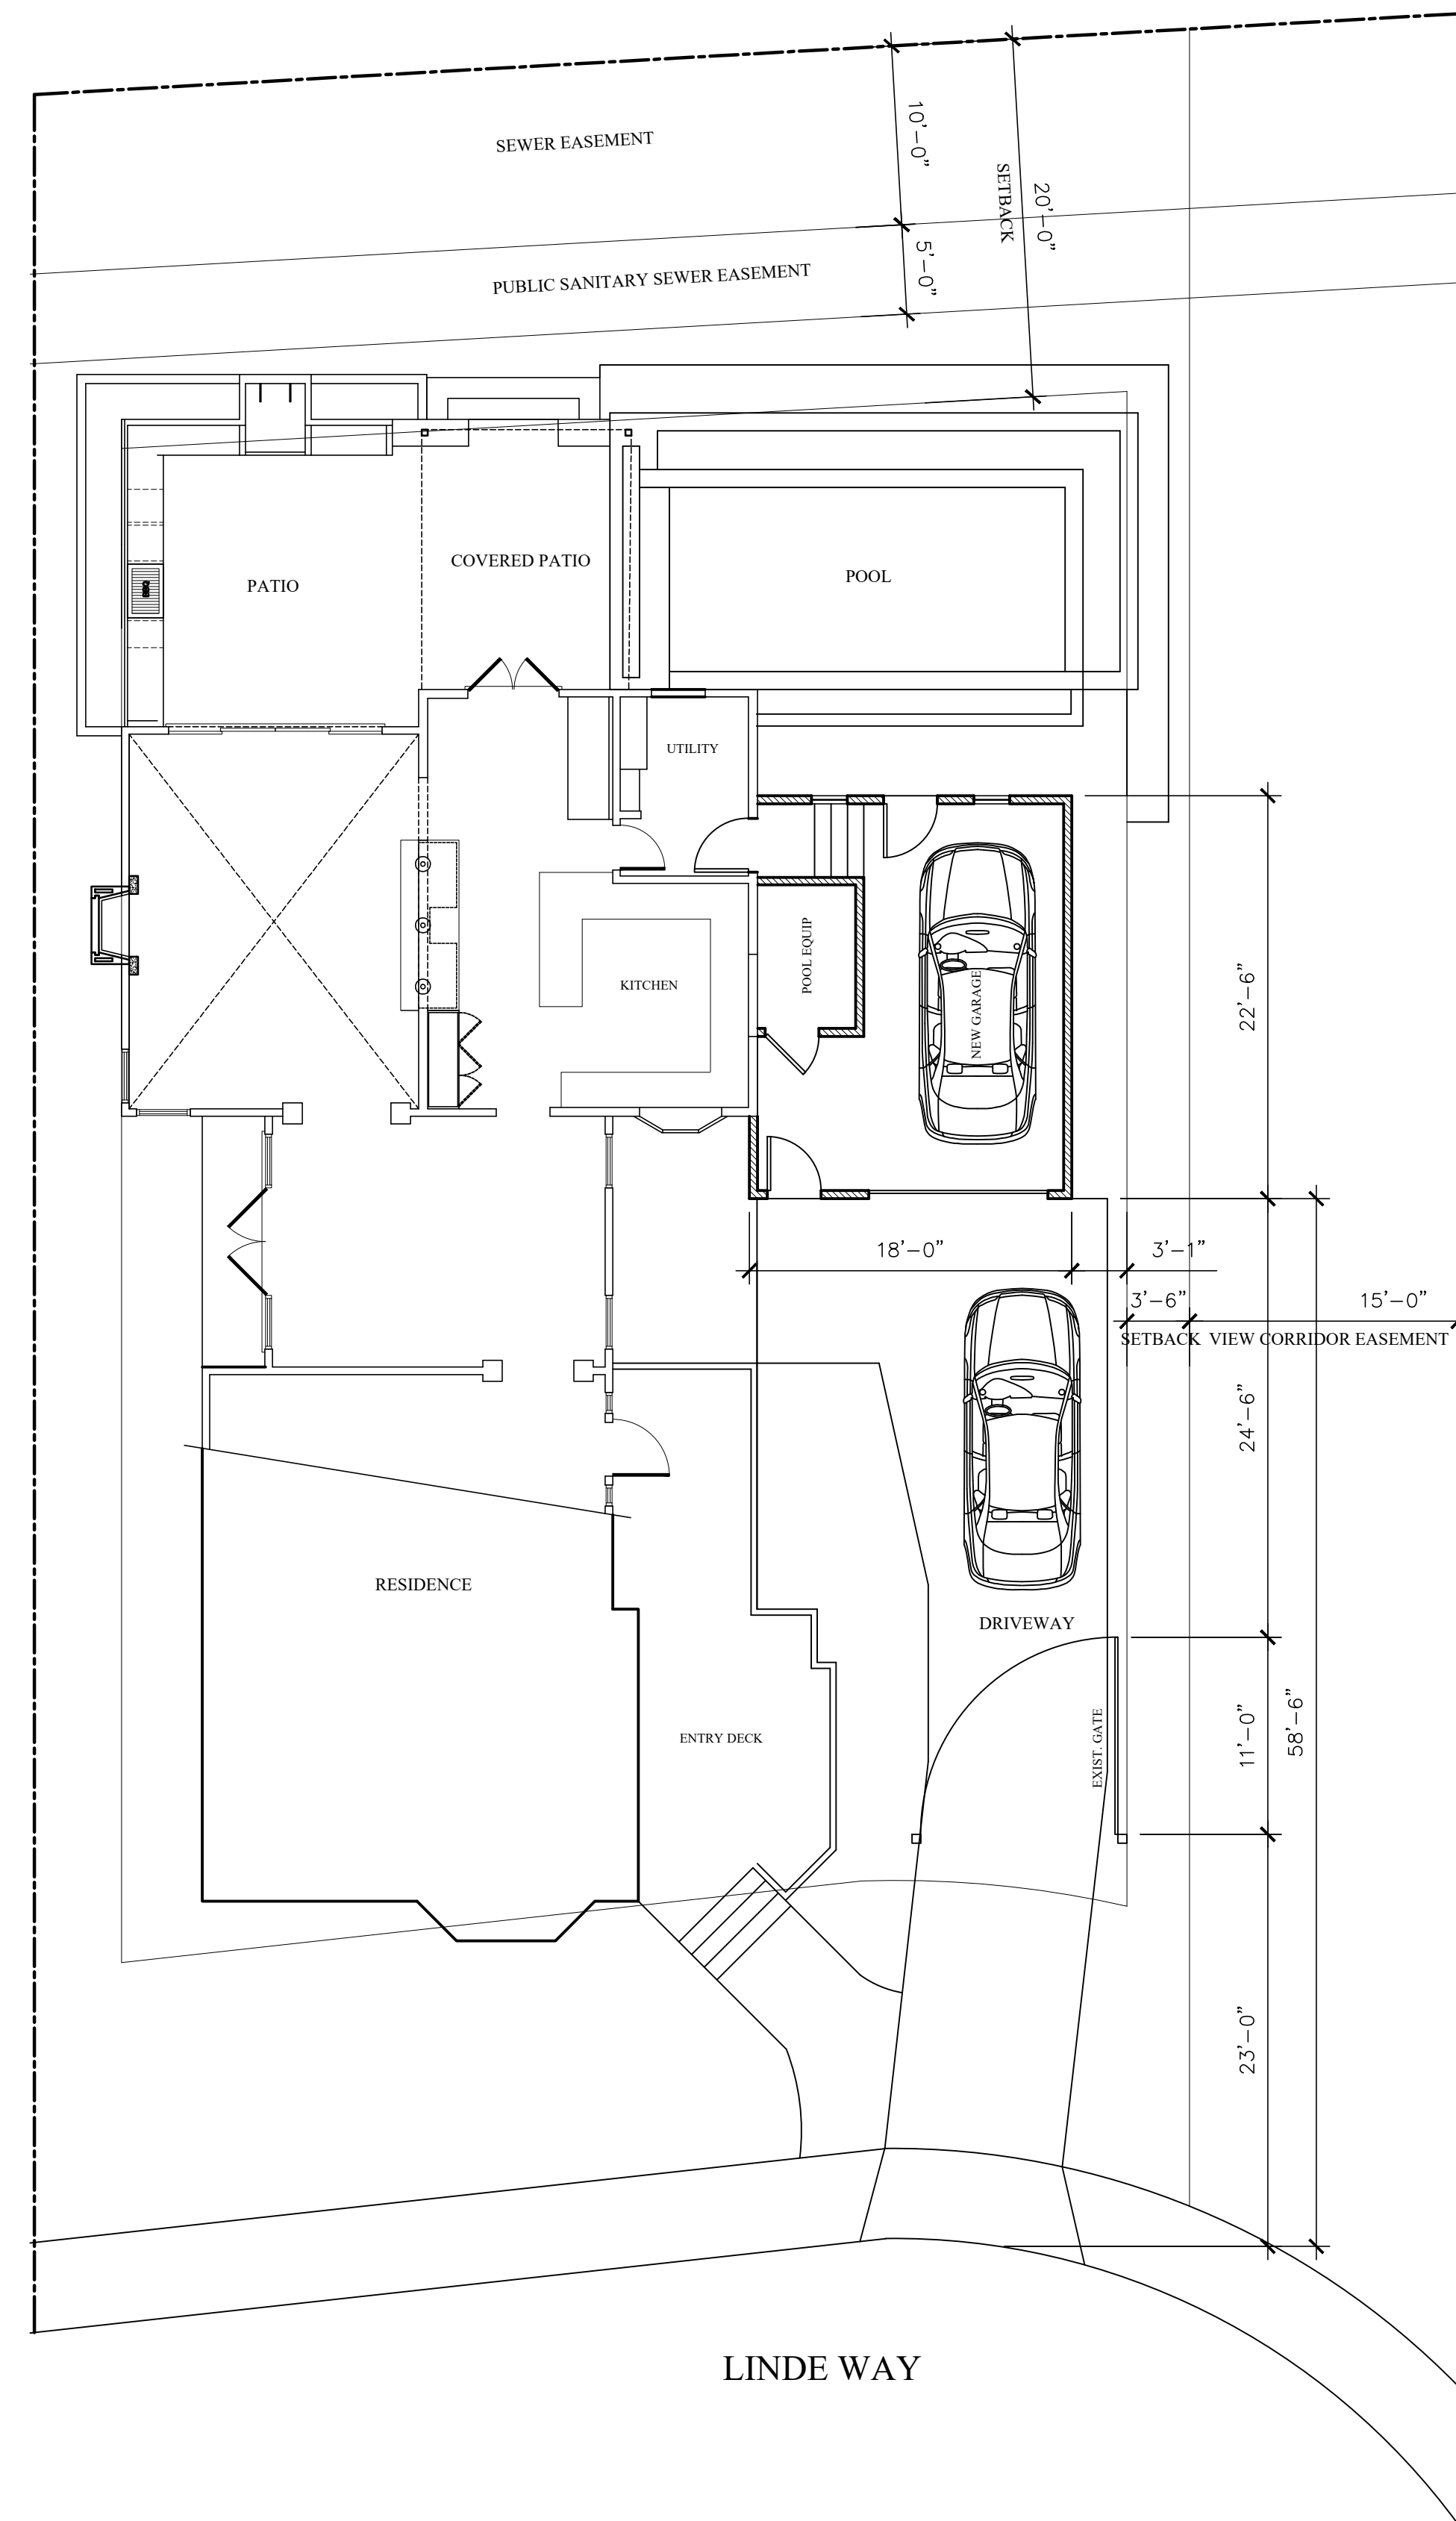

PROPOSED SITE PLAN

PRELIMINARY

Copyright

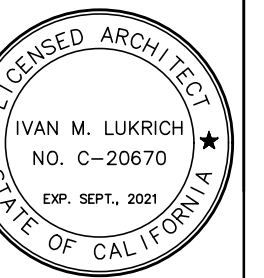

Revisions

IVAN M. LUKRICH
ARCHITECT
P.O. BOX 1642, SANTA ROSA, CA 95402
VOICE 707.573.8291 FAX 707.573.3012

SCHIESTEL RESIDENCE
RENOVATION
APN 036-463-016
1 LANDEWAY
YOUNTVILLE, CALIFORNIA

SITE PLAN

Job Number
SCHIESTEL

Drawn By
IML

Scale
1/4" = 1'-0"

Date
5-7-2021

Sheet Number

A1
of